



SECTION A-A


1024 (SCREW JACK STROKE)

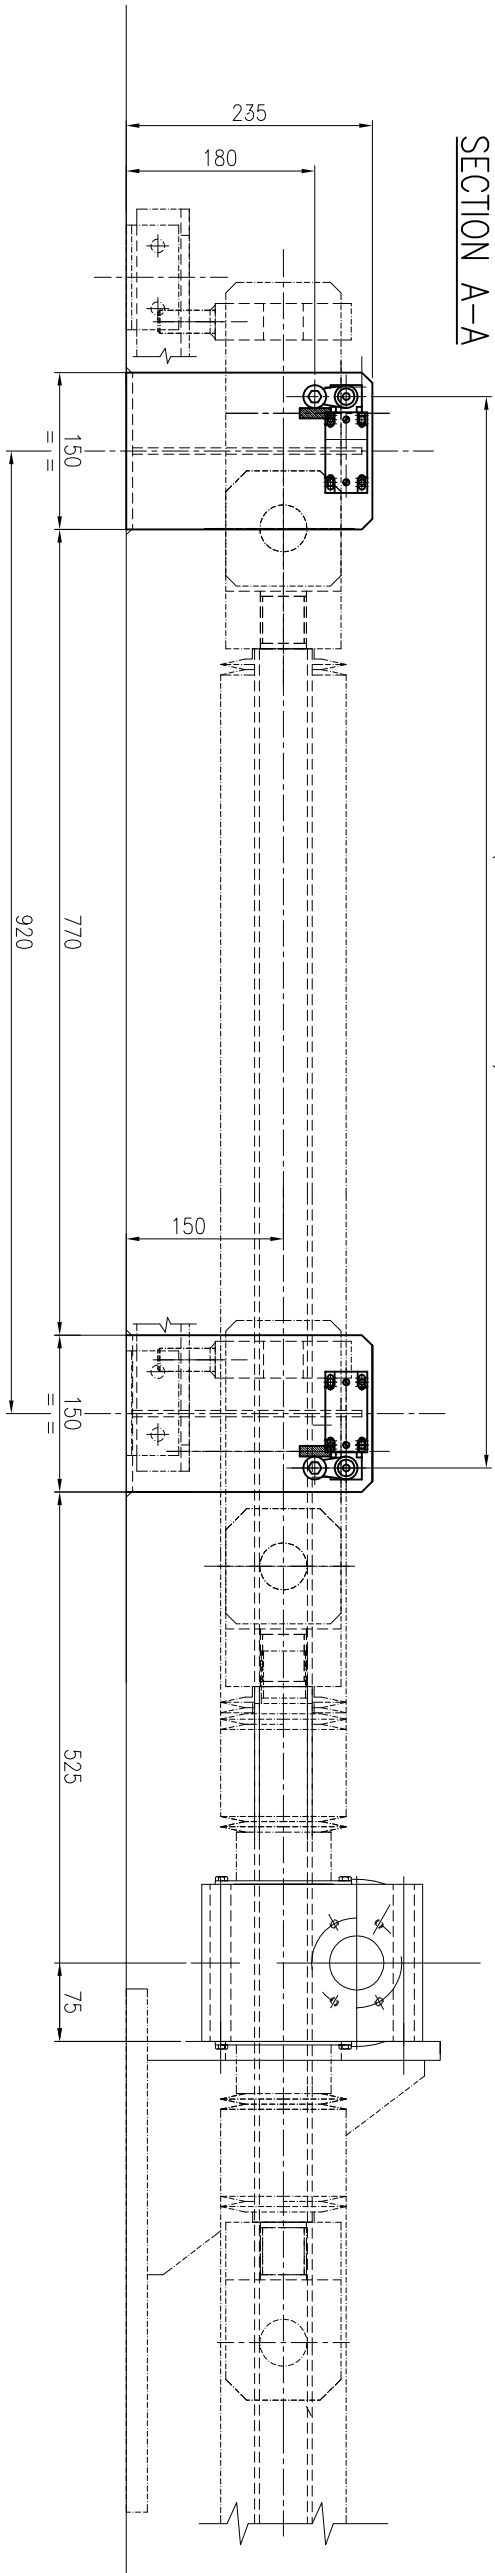

PLAN VIEW

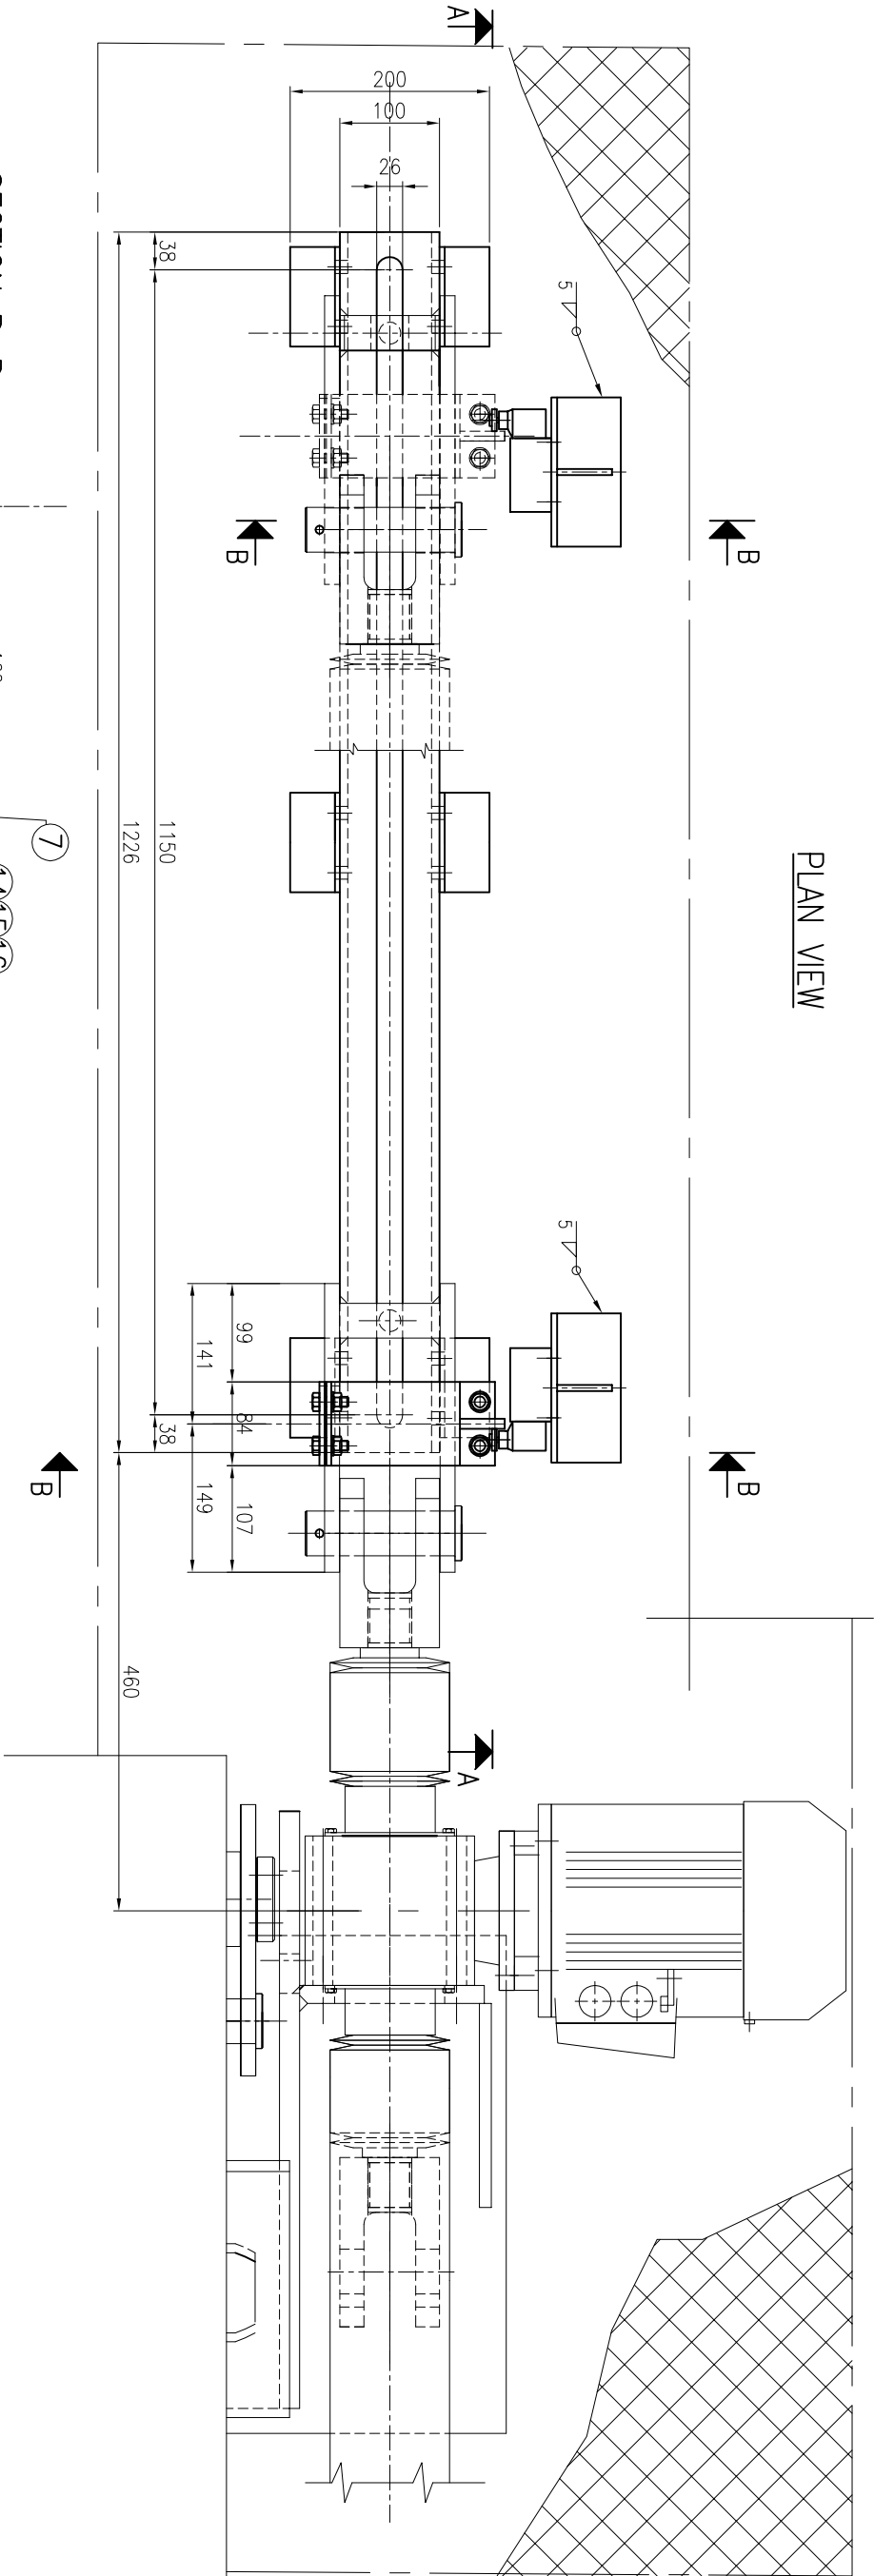

SECTION B-B  
SCALE 1:2.5

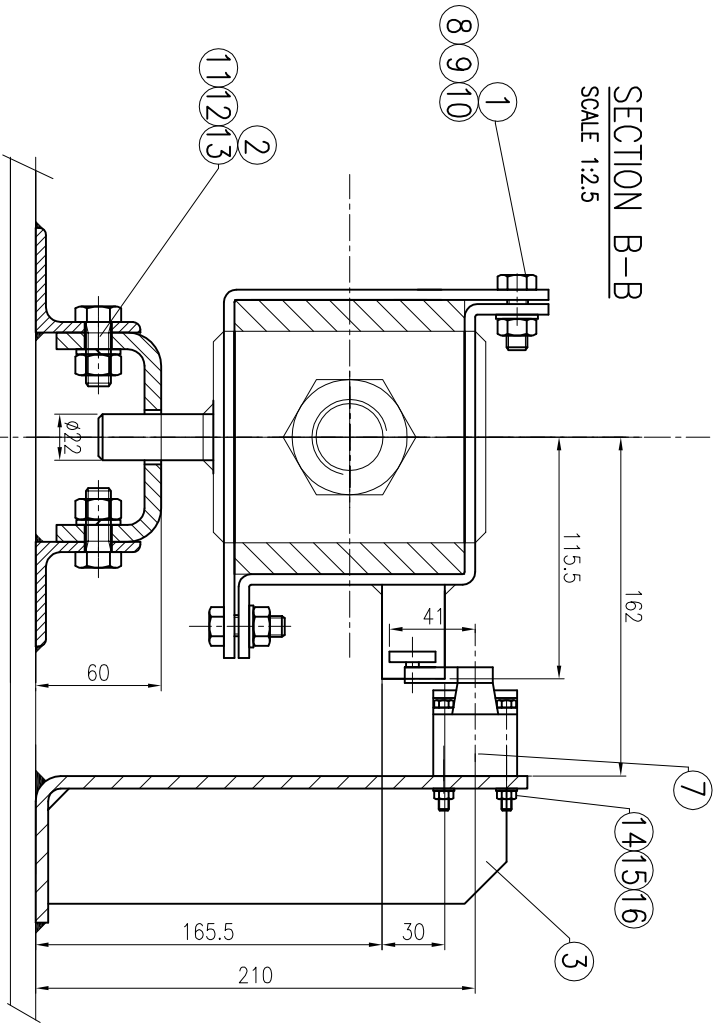

FOR N. 1 CRANE MANUFACTURE N.4 TIMES

DATA		MODIFICA ESEGUITA O MOTIVO DELLA SOSTITUZ.				DIS.	APP.
Fabb. di riferimento N.		MODIFICATION EXECUTED OR REASON OF THE REPLACEMENT				DRW.	
12834-5725		Material				Weight Kg	Scale
Treatement		Tol. gen. lav.				38	1:5
Customer PIRAEUS PORT AUTHORITY		Project: F0010				18/02/09	
Object: N.8 RMG 40t		Project: F0010				18/02/09	
Ref. Drawing		12834-5700				Pos. 25	
Comm. / Job		12834-5700				1/1	
N. 18033		N. 12834-5725					