 


	1	2	3	4
1				
2				
3				
4				



6