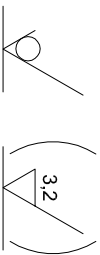


FOR N.1 CRANE MANUFACTURE N.4 PIECES

[illegible]

<u>MGM</u>		<b>ROKAS CONSTRUCTIONS S.A.</b>	Customer: PIRAEUS PORT AUTHORITY	D/S DRAWER	<i>LS</i>
<u>OMG</u>		TEL.: +30-2108774100 FAX: +30-2108774121 or *111 <a href="http://WWW.ROKASGROUP.GR">WWW.ROKASGROUP.GR</a>	Object: N.8 RMG 40t	VER.	DB
		Project: F0010		APP.	RM
					DATE
					13/01/09

ROP GUIDE ASSEMBLY

## ROLLER SUPPORT

N. 18033

N. 12834-5583

Formato: A3