



FOR N. 1 CRANE MANUFACTURE N.6 PIECES

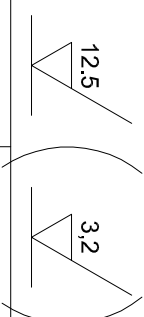


<u>MGM</u> <u>OMG</u>		ROKAS CONSTRUCTIONS S.A. TEL +302108774100 FAX +302108774121 or 111 WWW.ROKASGROUP.GR		Customer: PIRAEUS PORT AUTHORITY Object: N.8 RMG 40t Project: F0010		DIS. DRAWER		<i>S.B.</i>	
PIRAEUS PORT AUTHORITY		Dis. di riferimento N.		12834-5700		Pos.		22	
TRIM/LIST/SKEW		Comm. / Job		Disegno / Drawing		1/1			
PIN		N.		18033		N.		12834-5721	

Formato: A4

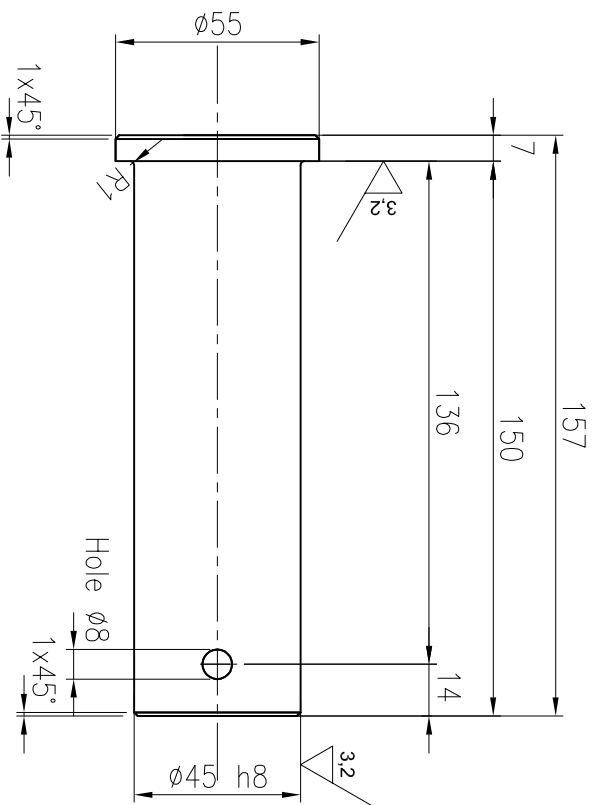

FOR N. 1 CRANE MANUFACTURE N.6 PIECES

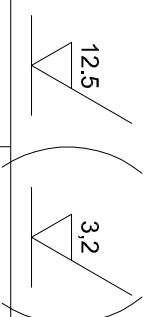

<u>MGM</u> <u>OMG</u>		ROKAS CONSTRUCTIONS S.A. TEL +302108774100 FAX +302108774121 or 111 WWW.ROKASGROUP.GR		Customer: PIRAEUS PORT AUTHORITY Object: N.8 RMG 40t Project: F0010		DIS. DRAWER		<i>S.B.</i>	
PIRAEUS PORT AUTHORITY		Dis. di riferimento N.		12834-5700		Pos.		22	
TRIM/LIST/SKEW		Comm. / Job		Disegno / Drawing		1/1			
PIN		N.		18033		N.		12834-5721	

Formato: A4