


MATERIALS:
SHAFT , SHELL and FLANGE : S355J0 or Equivalent

FOR N.1 CRANE MANUFACTURE N.1 PIECE

01	09/03/09	REVISED WEIGHT	GF	RM
00	11/02/09	FIRST ISSUE	GF	RM
	DATA DATE	MODIFICA ESEGUITA O MOTIVO DELLA SOSTITUZIONE MODIFICATION EXECUTED OR REASON OF THE REPLACEMENT	DIS. DRAWER	APP.

Fabb. di riferimento N. 12834-5520		Materiale See Material List		Trattamento trattamento H1+D11		Tot. gen. lav. 11+11		Mod. o stampo type		Peso, kg 1749		Scala 1:10	
		ROKAS CONSTRUCTIONS S.		Customer: PIRAELOS PORT AUTHORITY Project: F0010		Disegn. N.8 RMG 40C VER.		DB RM		DATE 11/02/09		C/F	

Dis. di riferimento N. Rel. Drawing		Pos.
12834-5500		1
Disegno / Drawing		1/1
Comm. Job		
N. 18033	N. 12834-5520	01