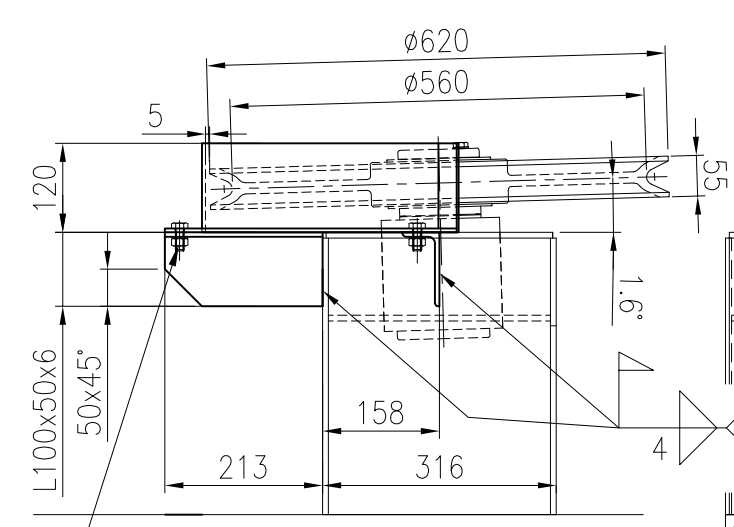

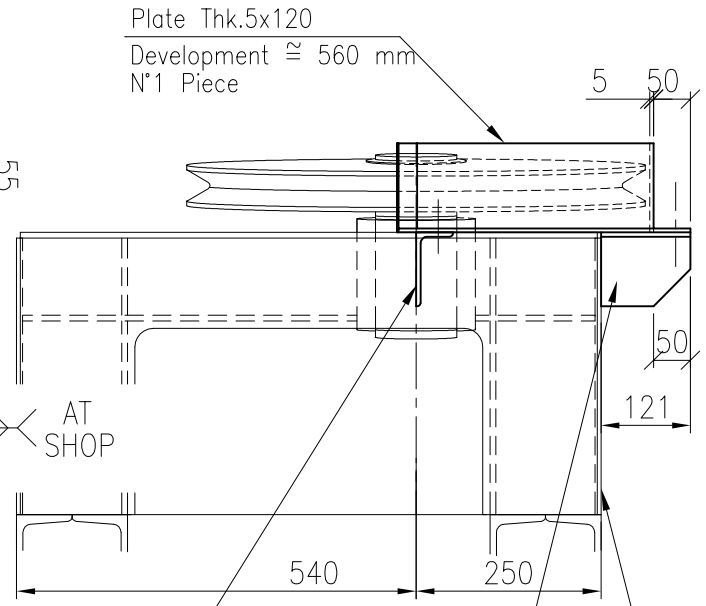

Screw M12x30 DIN933–N°2 Pieces
Washer A13 DIN127A–N°2 Pieces
Nut M12 DIN934–N°2 Pieces
HOT DIP GALVANIZED

PROFILE L 100x50x6
Lenght = 213 mm
N°1 Piece

PROFILE L 100x50x6
Lenght = 121 mm
N°1 Piece

HORIZONTAL SHEAVE
ASSEMBLY
See drwg. 12834–5557

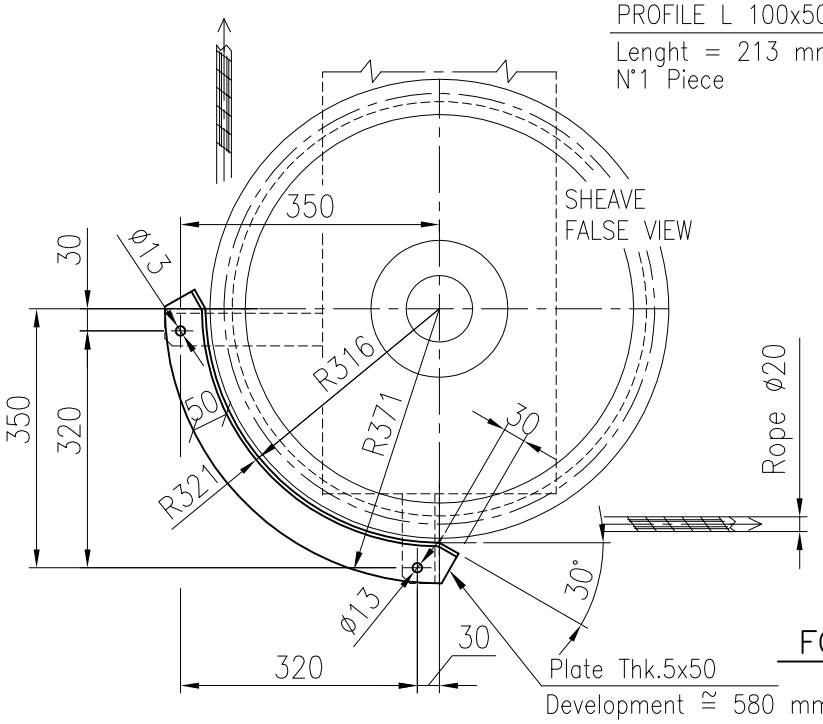

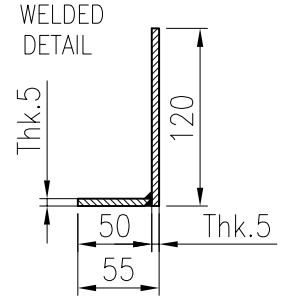

FOR N.1 CRANE MANUFACTURE
N.1 PIECE at DRAWING
+ N°1 OPPOSITE HAND

(*) Material : S235JR or Equivalent

00	28/02/09	FIRST ISSUE	GF	RM
	DATA DATE	MODIFICA ESEGUITA O MOTIVO DELLA SOSTITUZ. MODIFICATION EXECUTED OR REASON OF THE REPLACEMENT	DIS. DRAWER	APP.

Fabb. di riferimento N. Ref. material list	Materiale Material	Trattamento Treatment	Toll. gen. lav. Mach tolerance	Mod. o stampo Type	Peso Weight Kg	Scala Scale
12834–5000	(*)		H11–d11		6	1:10

MGM OMG

ROKAS
CONSTRUCTIONS S.A.
TEL. +30-2108774100
FAX +30-2108774121 or 111 WWW.ROKASGROUP.GR

Customer: PIRAEUS PORT AUTHORITY
Object: N.8 RMG 40t
Project: F0010

DIS. DRAWER	GF	
VER.	DB	DATA DATE
APP.	RM	28/02/09

Dis. di riferimento N. Ref. Drawing: 12834–5000 | Pos. 13 | 00

CARTER
FOR HORIZONTAL SHEAVE Ø560

Comm. /Job N. 18033

Disegno / Drawing N. 12834–5567 | 1/1